
DOOR AND FRAME SCHEDULE

DOOR NUMBER	FIRE RATING	DOOR PANELS						DOOR FRAME		HEAD	JAMB	HW SET	COMMENTS
		PANEL TYPE		PANEL DIMENSIONS			FINISH 1	TYPE	FINISH 1				
		PANEL 1	PANEL 2	WIDTH PANEL 1	WIDTH PANEL 2	HEIGHT							
LEVEL 1													
100A		PNL-FG-AL	PNL-FG-AL	3'-0"	3'-0"	9'-0"	SEE COMMENTS	FRM-00AL(CW)	SEE COMMENTS			1.0	SHOP FINISH, COLOR SELECTED BY ARCHITECT
101A		PNL-FG-WD		3'-0"		7'-0"	STAIN	FRM-00HM1	PAINT			11.0	PANEL STAIN TO MATCH ADJACENT WALL PANEL WOOD
102A		PNL-E11-WD		3'-0"		7'-0"	STAIN	FRM-00HM1	PAINT			8.0	PANEL STAIN TO MATCH ADJACENT WALL PANEL WOOD
103A		PNL-E11-WD		3'-0"		7'-0"	STAIN	FRM-00HM1	PAINT			13.0	
104A		PNL-E11-WD		3'-0"		7'-0"	STAIN	FRM-00HM1	PAINT			9.0	
104B		PNL-F-WD		3'-0"		7'-0"	PAINT	FRM-00HM1	PAINT			10.0	
105A		PNL-F-WD		3'-0"		8'-0"	STAIN	FRM-CONCEALED	PAINT			12.0	STAIN PANEL TO MATCH AND BE FLUSH WITH ADJACENT WOOD PANELS.
105B		PNL-F-WD		2'-8"		7'-0"	PAINT	FRM-00HM1	PAINT			14.0	
106A		PNL-FG-AL	PNL-FG-AL	3'-0"	3'-0"	9'-0"	SEE COMMENTS	FRM-00AL(CW)	SEE COMMENTS			4.0	SHOP FINISH, COLOR SELECTED BY ARCHITECT
107A		PNL-F-WD		3'-0"		6'-8"	STAIN	FRM-CONCEALED	PAINT			17.0	STAIN PANEL TO MATCH AND BE FLUSH WITH ADJACENT WOOD PANELS.
107B		PNL-E11-WD		3'-0"		7'-0"	STAIN	FRM-00HM1	PAINT			2.0	PANEL STAIN TO MATCH ADJACENT WALL PANEL WOOD
110A		PNL-E11-WD		3'-0"		7'-0"	STAIN	FRM-00HM1	PAINT			5.0	
110B		PNL-FG-AL	PNL-FG-AL	3'-0"	3'-0"	7'-0"	SEE COMMENTS	FRM-00AL(CW)	SEE COMMENTS			1.0	SHOP FINISH, COLOR SELECTED BY ARCHITECT
110C		PNL-FG-AL	PNL-FG-AL	3'-0"	3'-0"	7'-0"	SEE COMMENTS	FRM-00AL(CW)	SEE COMMENTS			1.0	SHOP FINISH, COLOR SELECTED BY ARCHITECT
111A		PNL-N-WD		3'-0"		7'-0"	STAIN	FRM-00HM1	PAINT			15.0	
112A		PNL-E32B-WD		3'-0"		7'-0"	STAIN	FRM-00HM1	PAINT			16.0	
113A		PNL-E11-WD		3'-0"		7'-0"	STAIN	FRM-00HM1	PAINT			16.0	
114A		PNL-E32B-WD		3'-0"		7'-0"	STAIN	FRM-00HM1	PAINT			14.0	
115A		PNL-FG-WD		3'-0"		7'-0"	STAIN	FRM-00HM1	PAINT			11.0	
116A		PNL-E32B-WD		3'-0"		7'-0"	PAINT	FRM-00HM1	PAINT			7.0	
117A		PNL-N-WD		3'-0"		7'-0"	STAIN	FRM-00HM1	PAINT			15.0	
118A		PNL-F-HM		3'-0"		7'-0"	PAINT	FRM-00HM1	PAINT			3.0	
121A		PNL-F-WD		3'-0"		7'-0"	PAINT	FRM-00HM1	PAINT			14.0	

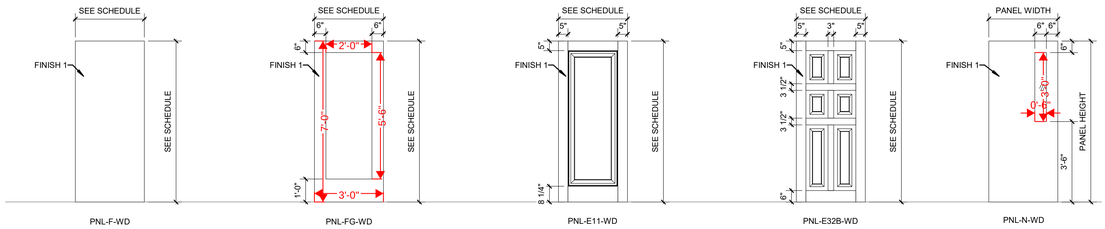


DOOR PANEL TYPE LEGEND

3/8" = 1'-0"



DOUBLE DOOR PANEL TYPE LEGEND

3/8" = 1'-0"

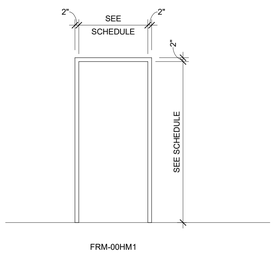

FRAME TYPE LEGEND

3/8" = 1'-0"

5/29/2026 1:36:04 PM

FIRST BAPTIST SCHOOL OF CHARLESTON

LS3P

205 1/2 KING STREET
CHARLESTON, SOUTH CAROLINA 29401
TEL. 843.577.4444 FAX. 843.722.4789
WWW.LS3P.COM

NOT FOR CONSTRUCTION

COPYRIGHT 2026 ALL RIGHTS RESERVED. PRINTED OR ELECTRONIC DRAWINGS AND DOCUMENTATION MAY NOT BE REPRODUCED IN ANY FORM WITHOUT WRITTEN PERMISSION FROM LS3P ASSOCIATES LTD.

FIRST BAPTIST HIGH SCHOOL PHASE III - CHAPEL

2051 George L. Griffith Blvd
Charleston, South Carolina 29412

LS3P PROJECT: 1201-224055

Δ	DATE	DESCRIPTION

SHEET NAME:
DOOR SCHEDULE, DOOR AND FRAME TYPE LEGEND

ORIG SUBMISSION: 05/29/2026

SHEET:
A-601

DESIGN DEVELOPMENT